

Town of Hingham Conservation Commission
Request for Determination of Applicability (RDA)

Requester / Contact Information:

Robb Giardino
215 Hersey Street Hingham, MA 02043

RECEIVED

FEB 05 2021

TOWN OF HINGHAM
CONSERVATION

PROJECT PLAN – Narrative Describing Proposed Activity

Build a retaining wall constructed of 6"x6" timbers at the base of the existing "RipRap Slope" in the backyard (at the 50' Wetland Buffer) which will have a height of 36"- 48" maximum. Backfill the area behind the wall (the current RipRap Slope), and then install a metal black fence at the top (just inside) of the retaining wall.

REFER TO PROJECT PLAN SCHEMATIC FOR DETAILS

**The project plan is the "Site As Built Plan" with added text, picture, and red dashed line showing the proposed location.*

LOCUS INFORMATION
 CURRENT OWNER:
 ROBB EDWARD AND
 NICOLE IVERLISSE GIARDINO

OWNERS REFERENCE:
 LCC 126162

ASSESSORS REFERENCE:
 MAP 89 LOT 44

LOT AREA:
 20,413 S.F.

ZONE:
 RA

FEMA REF:
 ZONE A AND ZONE X
 25023C0082J
 DATED 7-17-12

HOYT LAND SURVEYING
 1287 WASHINGTON STREET
 WEYMOUTH MA. 02189
 781-682-9192

SITE AS-BUILT PLAN
215 HERSEY STREET
HINGHAM, MA

SCALE 1" = 30' DATE 7-23-18

30 15 0 30 60

GRAPHIC SCALE SCALE: 1"=30'

I CERTIFY:


1. THIS PLAN IS THE RESULT OF AN ACTUAL
 ON THE GROUND SURVEY.

PETER G. HOYT P.L.S.

RECEIVED
 JUL 26 2018
 TOWN OF HINGHAM
 CONSERVATION COMMISSION

PROJECT PLAN

Build a retaining wall constructed of 6"x6" timbers at the base of the existing "RipRap Slope" (at the 50' Wetland Buffer) which will have a height of 36"-48" maximum. Backfill the area behind the wall (the current RipRap Slope) and then install a metal black fence at the top (just inside) of the retaining wall.

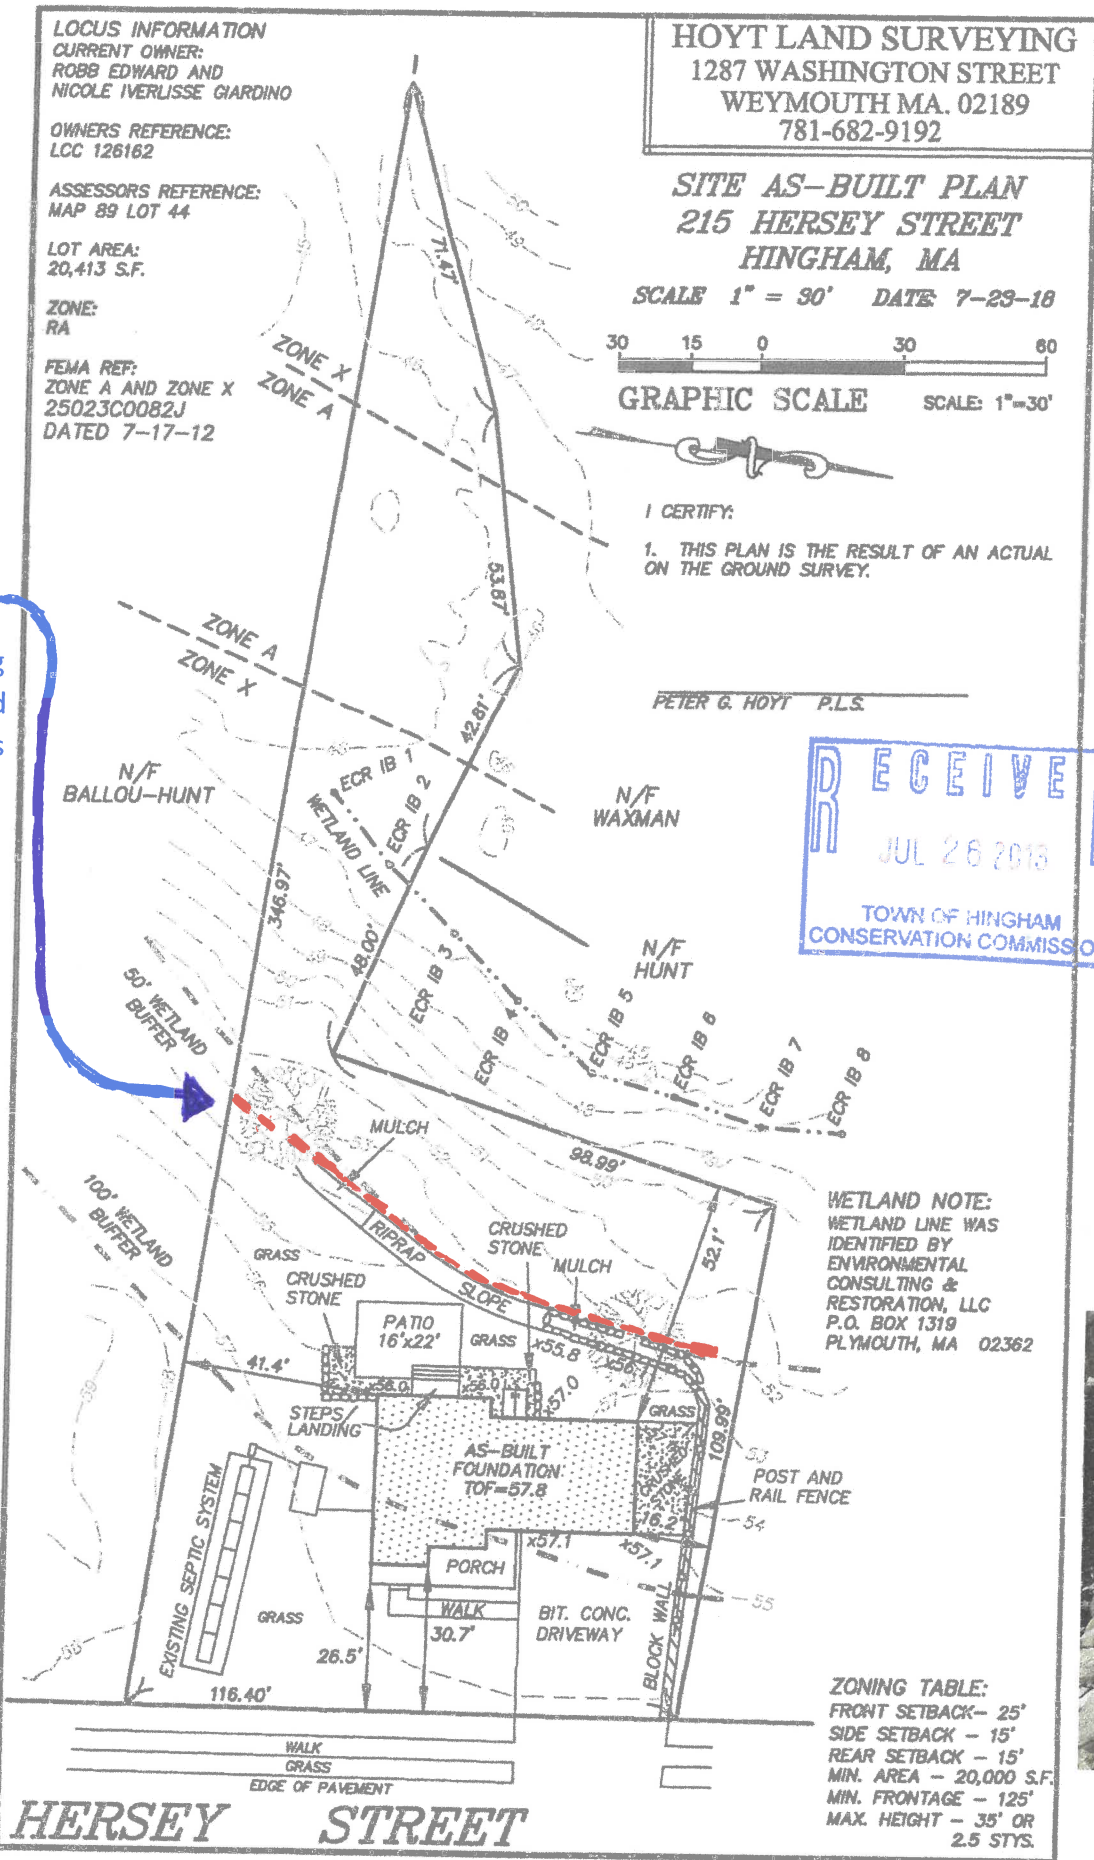

WETLAND NOTE:
 WETLAND LINE WAS
 IDENTIFIED BY
 ENVIRONMENTAL
 CONSULTING &
 RESTORATION, LLC
 P.O. BOX 1319
 PLYMOUTH, MA 02362

ZONING TABLE:
 FRONT SETBACK - 25'
 SIDE SETBACK - 15'
 REAR SETBACK - 15'
 MIN. AREA - 20,000 S.F.
 MIN. FRONTAGE - 125'
 MAX. HEIGHT - 35' OR
 2.5 STYS.

TOWN OF HINGHAM
 CONSERVATION COMMISSION

FEB 05 2021

RECEIVED

Picture current
 RipRap Boulder
 Wall

