


Brian McSweeney
 Consulting Civil & Sanitary Engineer
 150 UNION STREET
 HINGHAM, MASS. 02043
 749-2859

As Built Septic System
 Lot - C. Prospect Street - Hingham.
 BLAKE JULY 1983

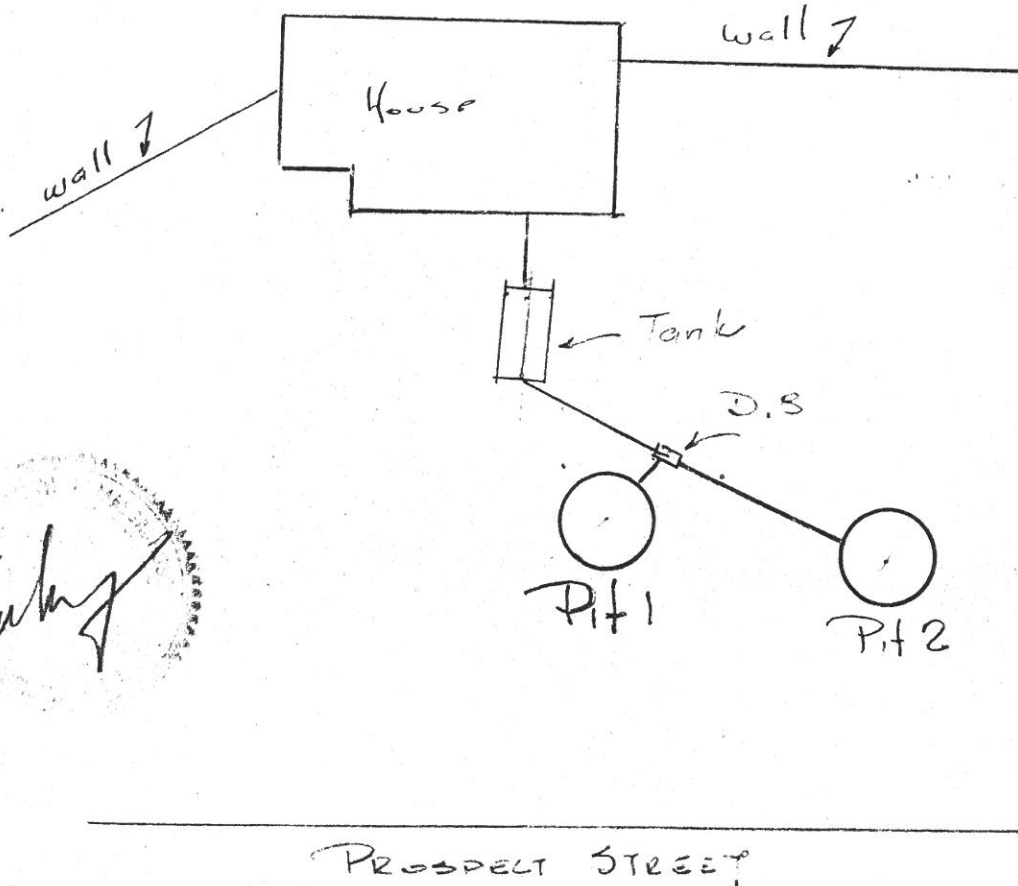

Blake

DISTANCE DATA.

CORNER A	To CORNER B	To	GRADE
20'	16'	M/TANK IN	131.4
25'	19'	M/TANK OUT - IN	131.15
45'	25'	D.S. IN	130.7
42'	31'	PIT 1 TOP	132.2
67'	46'	PIT 2 TOP	131.7
TOP WALL			132.4 MSL
TOP FNDT.			133.4
CELLAR FLOOR			134.4