



August 24, 2026

Town of Hingham
Conservation Commission
Hingham Town Hall
210 Central Street
Hingham, MA 02043
Attn: Shannon Palmer, Conservation Officer

RE: Revetment Restoration Completion, 93 Kimball Beach Road, Hingham, DEP File SE34-1381

Dear Ms. Palmer & Members of the Conservation Commission:

In accordance with the August 13th Enforcement Order issued by the Commission for the property at 93 Kimball Beach Road (the Site), the applicant completed the revetment restoration work on August 21, 2026. The restoration work followed the proposed restoration methodology and meets the designated profile as confirmed in the attached Asbuilt Plan prepared by Hoyt Land Surveying. ECR performed a site review on August 23rd and confirms there are no impacts to coastal resource areas such as the Salt Marsh, Coastal Beach, or buffer zone. The site is fully stable with no signs of erosion or sedimentation issues.

Included with this submittal are the following attachments:

1. Updated Asbuilt Plan
2. Photograph Pages



Upon review, please let us know if you have questions or require additional information to support the Request for Partial Certificate of Compliance under review.

Sincerely,
Environmental Consulting & Restoration, LLC

Brad Holmes, PWS, MCA
Manager

CC: David Castellani
Hoyt Land Surveying
Attorney Adam Brodskty, DTM, PC

HINGHAM HARBOR

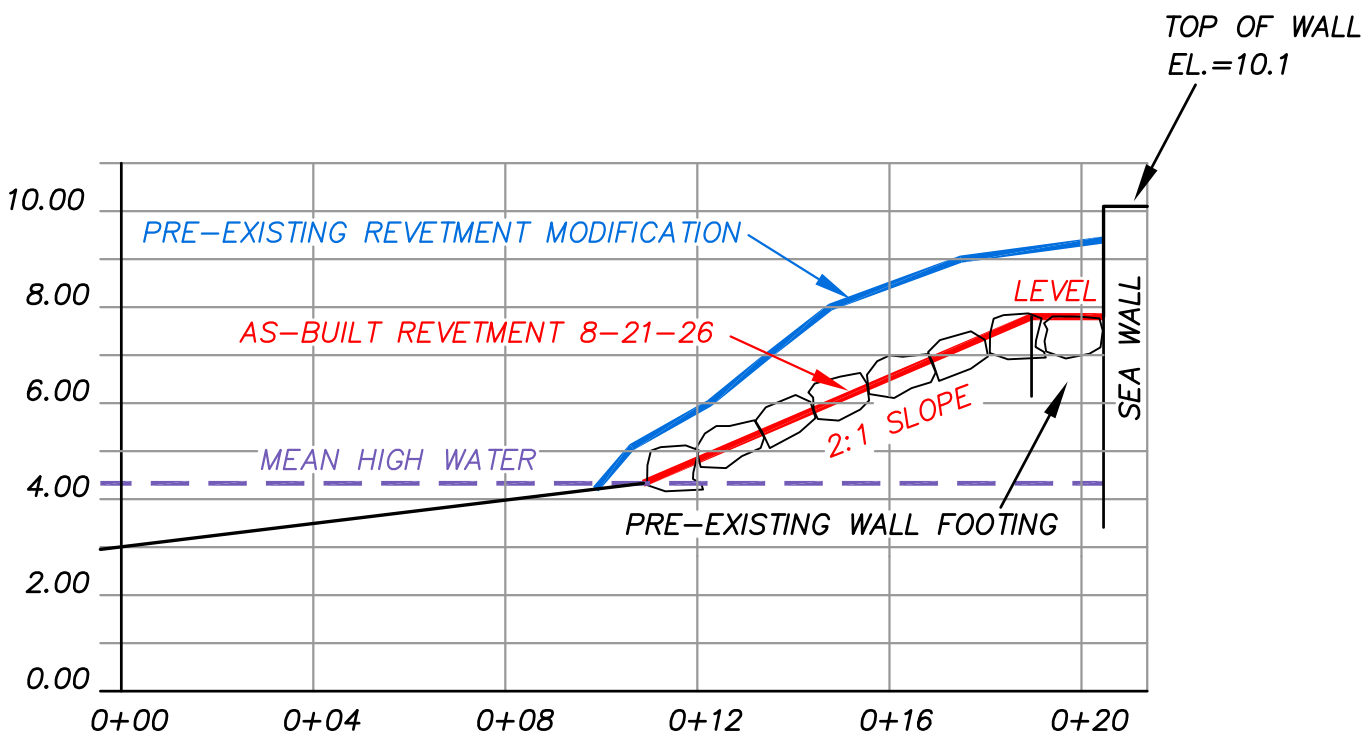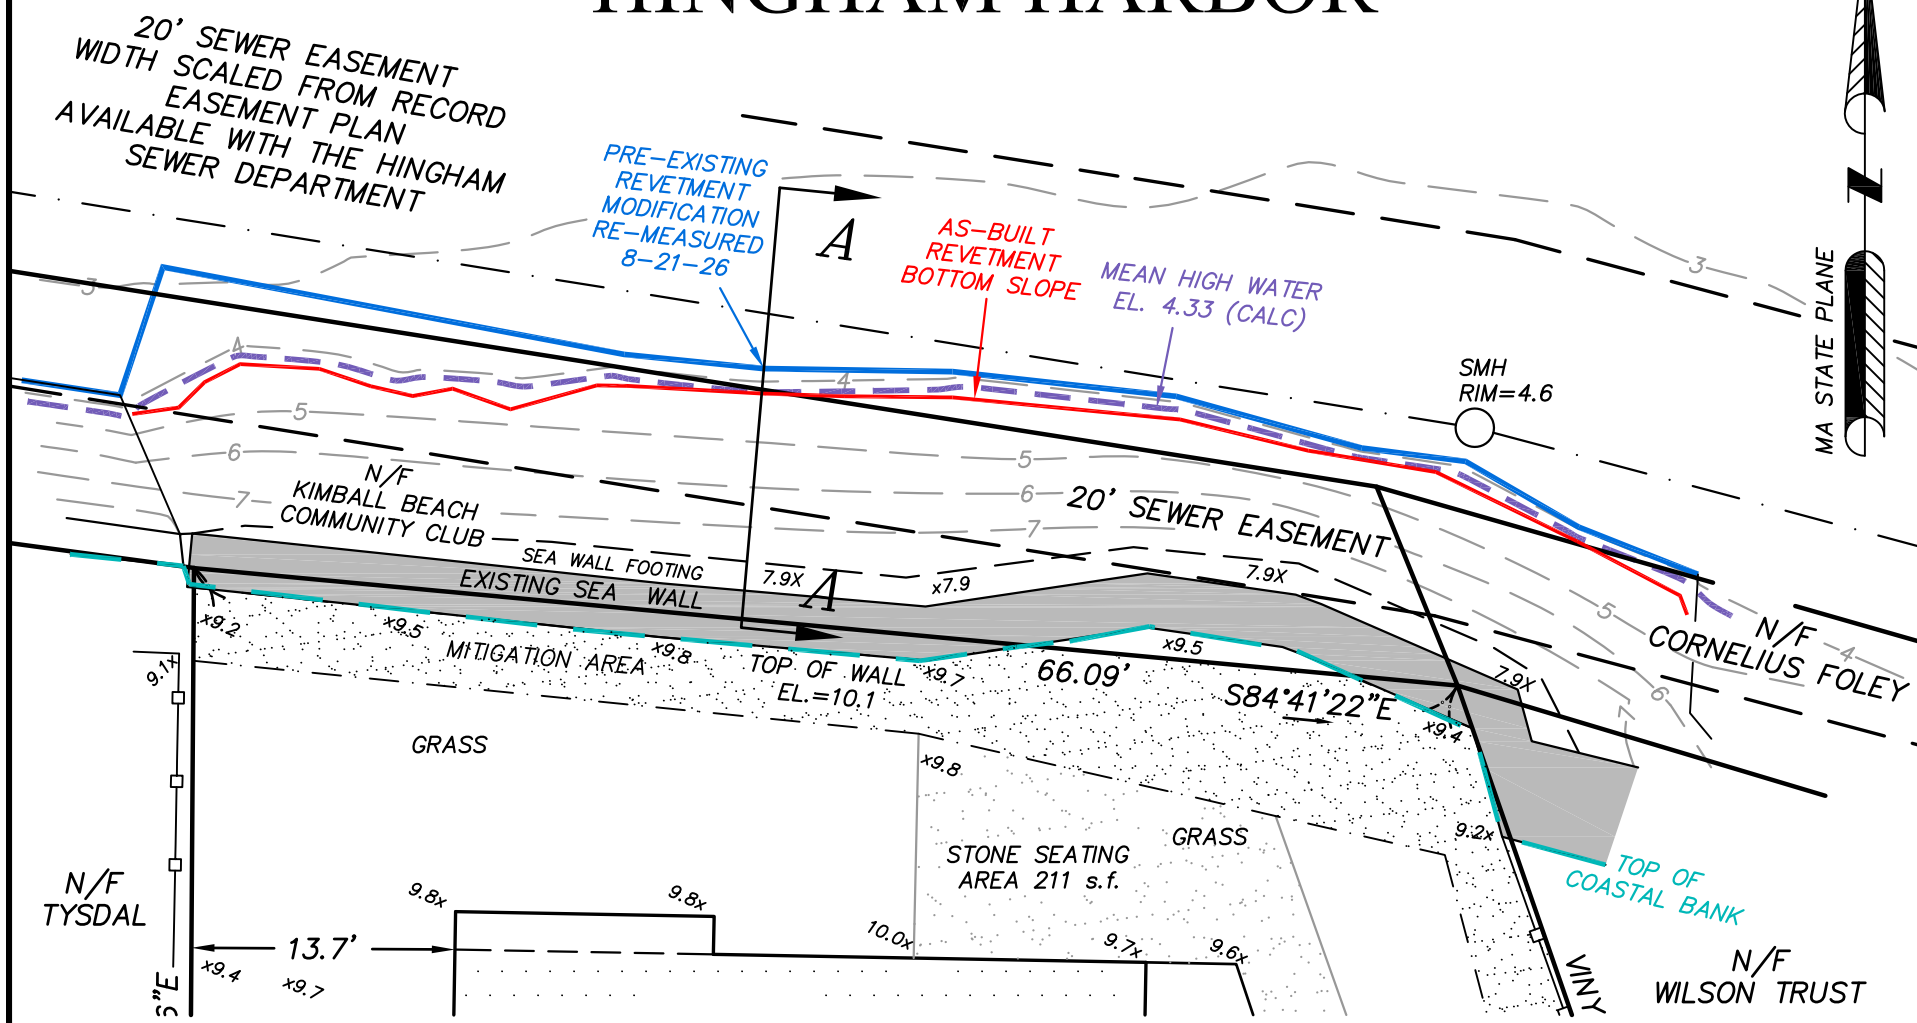

LOCUS INFORMATION
CURRENT OWNER:
DAVID J. AND
HEIDI CASTELLANI

OWNERS REFERENCE:
BOOK 56526 PAGE 253

ASSESSORS REFERENCE:
MAP 15 LOT 89

LOT AREA:
6,029 S.F. (CALC)


ZONE:
RA

VERTICAL DATUM:
NAVD 88

HORIZONTAL DATUM
NAD 1983

REVTMENT CROSS-SECTION A-A

SCALE: 1"=4'

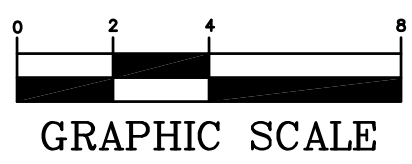

FEMA NOTE:
LOCUS PROPERTY LIES WITHIN A
FEMA ZONE AE 11 AS SHOWN ON
FIRM PANEL 25023C0018J DATED
7-17-2012.

SEE LOMR CASE NO. 15-01-0904P
DATED 8-14-15

I CERTIFY THAT THIS PLAN IS THE RESULT OF AN
ACTUAL ON THE GROUND SURVEY.


Peter G. Hoyt
PETER G. HOYT PLS



REVTMENT REMEDIATION AS-BUILT PLAN

93 KIMBALL BEACH ROAD
HINGHAM, MA

SCALE 1" = 10' DATE: 8-24-26
GRAPHIC SCALE

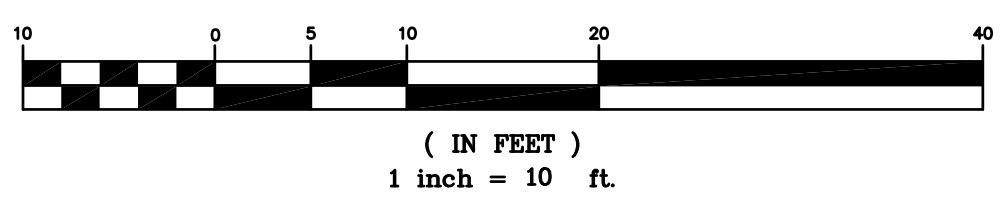

HOYT LAND SURVEYING

1287 WASHINGTON STREET
WEYMOUTH MA.02189
781-682-9192

SITE PHOTOGRAPHS



Photograph 1 – View east across the revetment restoration area.



Photograph #2 – View west across the revetment restoration area.



Photograph #3 – View west across the Salt Marsh.