



Volumes/Roundel 47 CAD Server/47342-HYC Deck JOL CAD/47342-260908-HYC/47342-260905-HYC 3D.pln

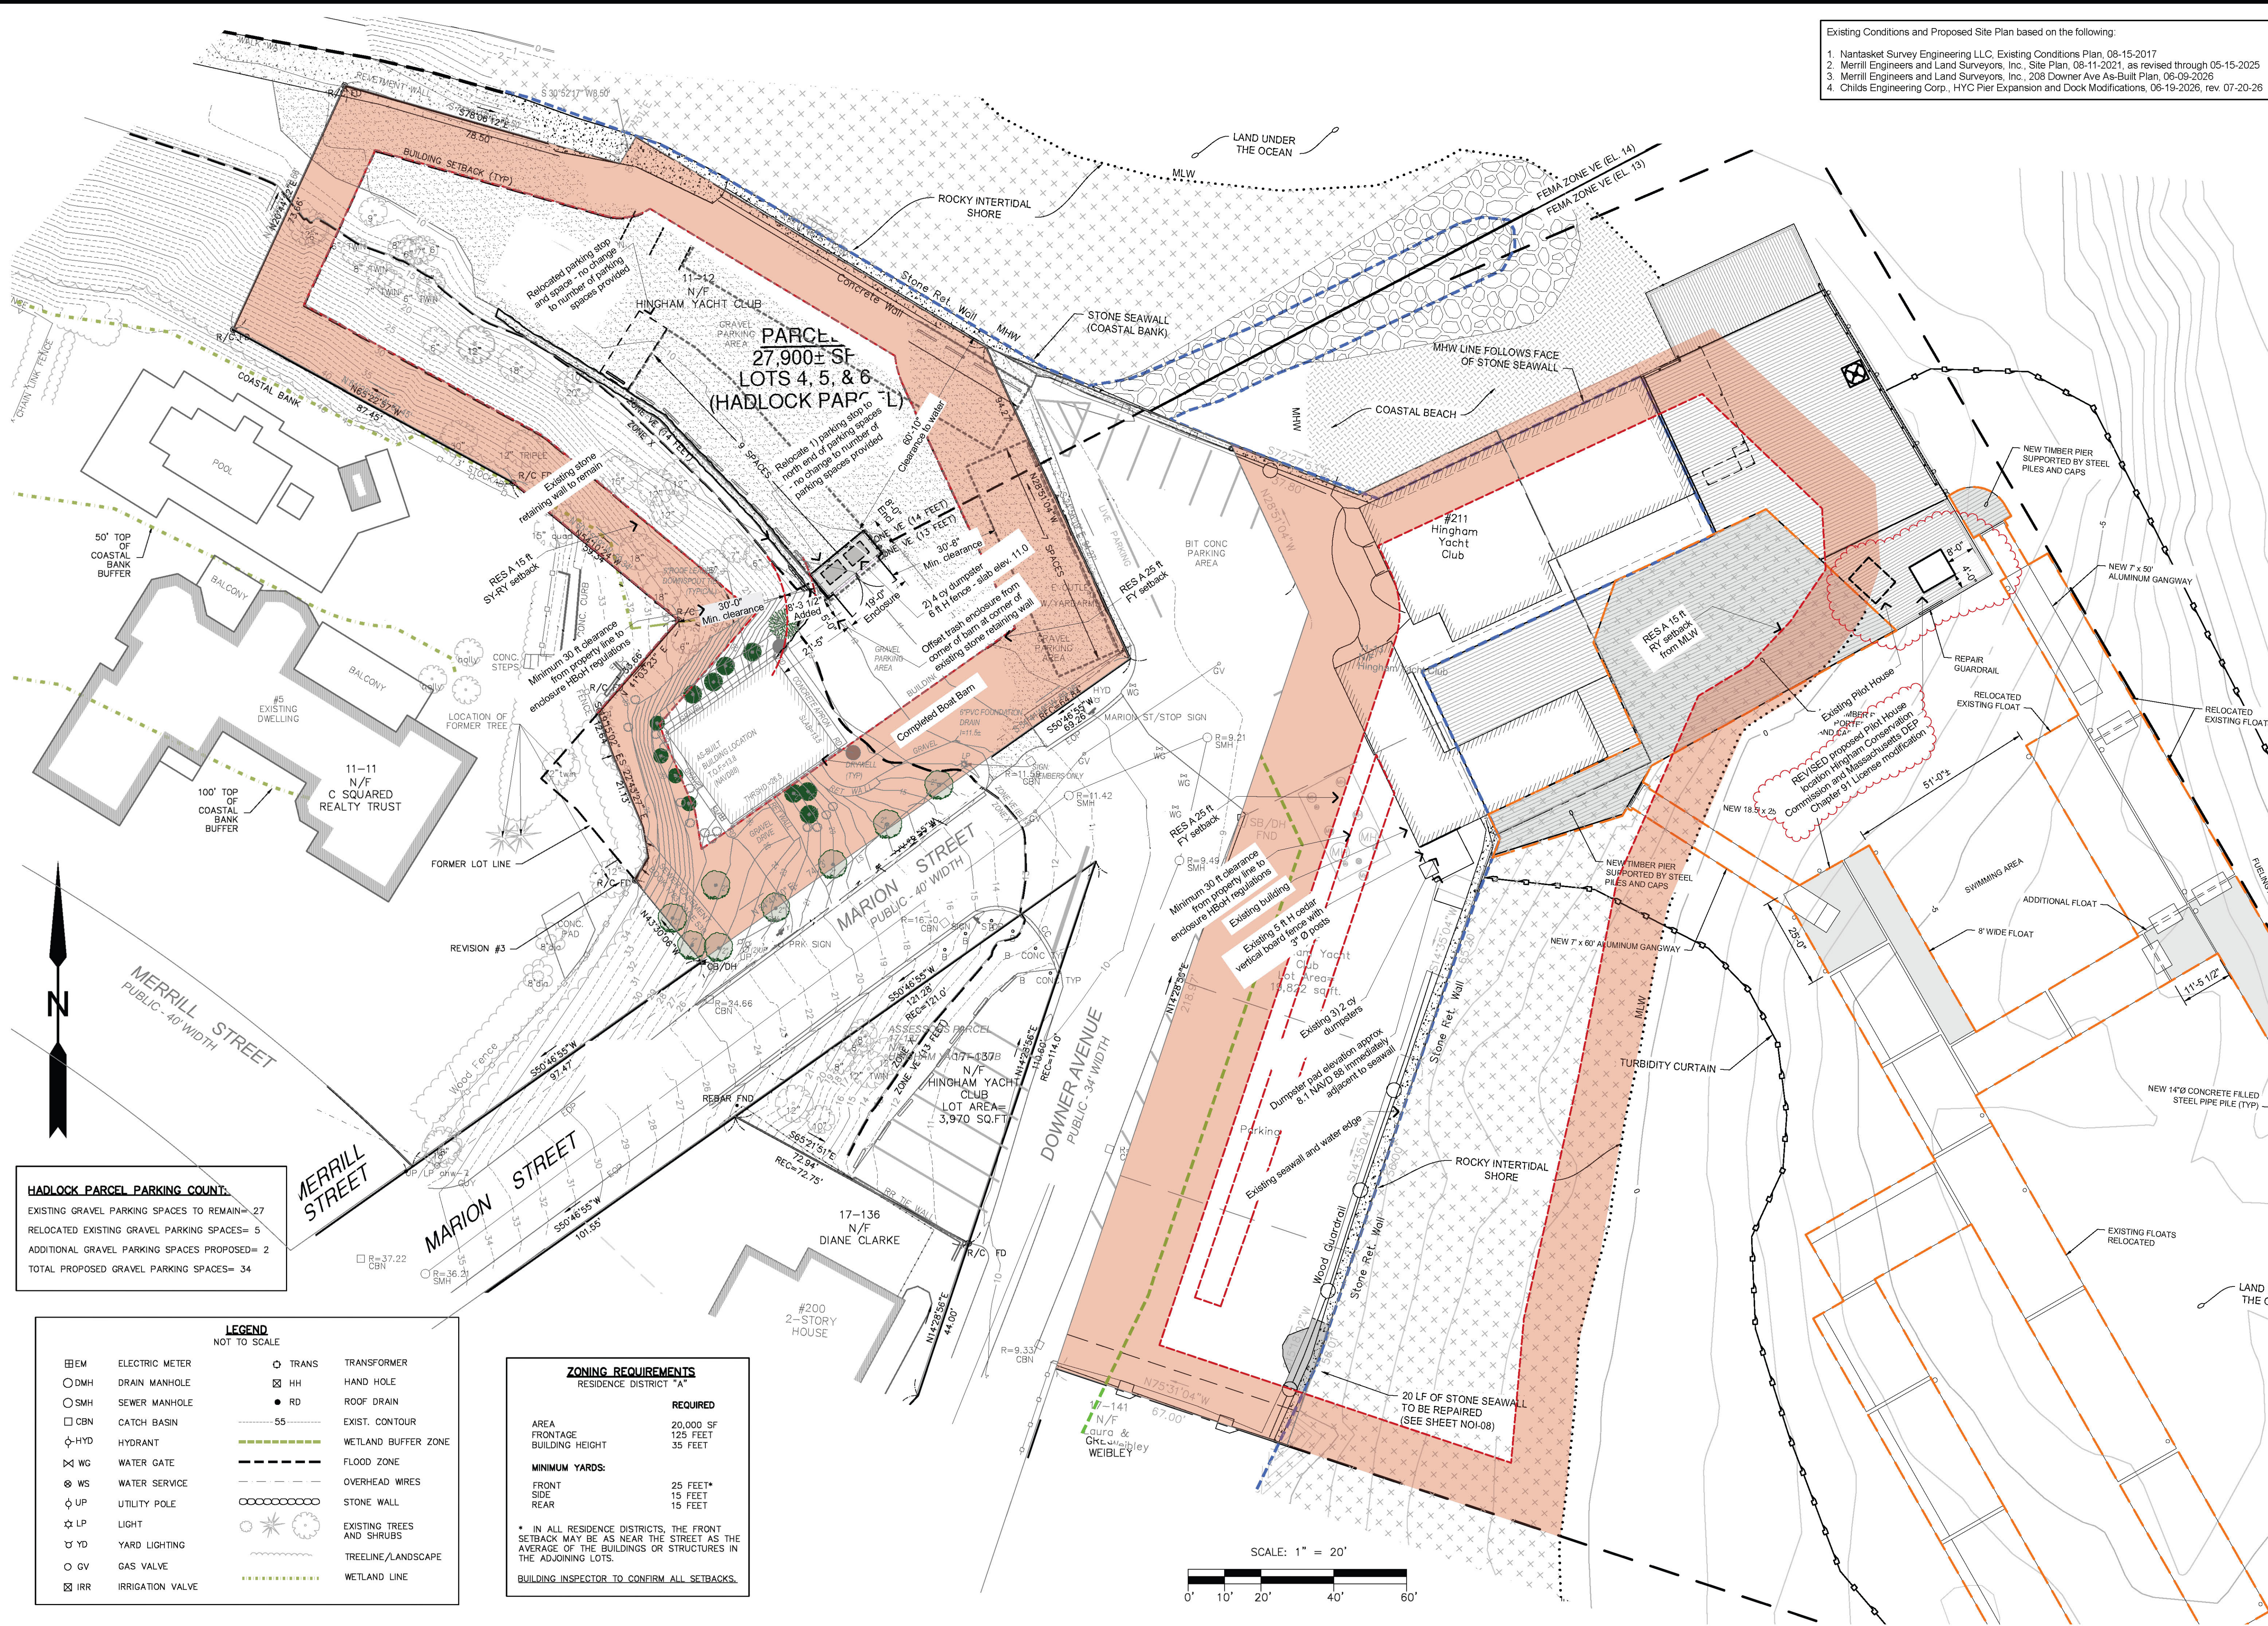


Existing Conditions and Proposed Site Plan based on the following:
1. Nantasket Survey Engineering LLC, Existing Conditions Plan, 08-15-2017
2. Merrill Engineers and Land Surveyors, Inc., Site Plan, 08-11-2021, as revised through 05-15-2025
3. Merrill Engineers and Land Surveyors, Inc., 208 Downer Ave As-Built Plan, 06-09-2026
4. Childs Engineering Corp., HYC Pier Expansion and Dock Modifications, 06-19-2026, rev 07-20-26

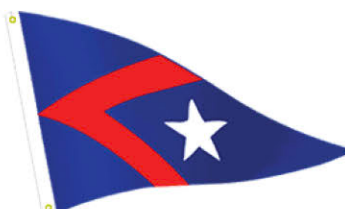

Hingham Yacht Club

Pier Expansion and Dock Modifications

208 and 211 Downer Ave.
Hingham, MA 02043

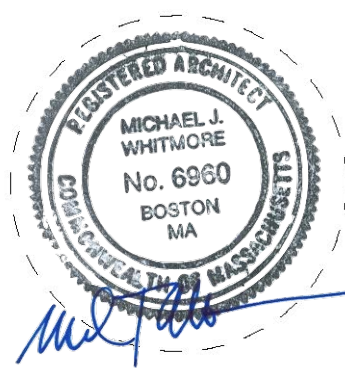

ARCHITECT
Roundel 47 LLC
46 Allen Place
Scituate, MA 02066
617-901-6307 mobile
mjwhitmore@roundel47.com

CONSULTANT

REVISION		
06-19-26	Hingham ConCom	
07-06-26	Hingham BoA app	
09-08-26	Hingham ConCom	Rev. Pilot House

MARK	DATE	DESCRIPTION
------	------	-------------

PROJECT NO: 47342
MODEL FILE:
DRAWN BY: AFW - MJW
CHK'D BY: MJW
COPYRIGHT

SHEET TITLE

Proposed Site Plan
Conservation

SI-02